


25.03.2010
3001-LAYOUT
3rd DOOR
J.P. VAN NELLE, ARCHITECT
DESIGNER / COLLECTOR /
PROJECT MANAGER / P.E.C.

SCALE 1:300
DATE 25.03.2010
PROJECT 3001-LAYOUT
CLIENT J.P. VAN NELLE
DESIGNER J.P. VAN NELLE
COLLECTOR J.P. VAN NELLE
PROJECT MANAGER J.P. VAN NELLE



www.interiors.nl
Lindendreef 2, 5317 JP, Eindhoven
Tel: +31 (0)496 301 301 Fax: +31 (0)496 301 302

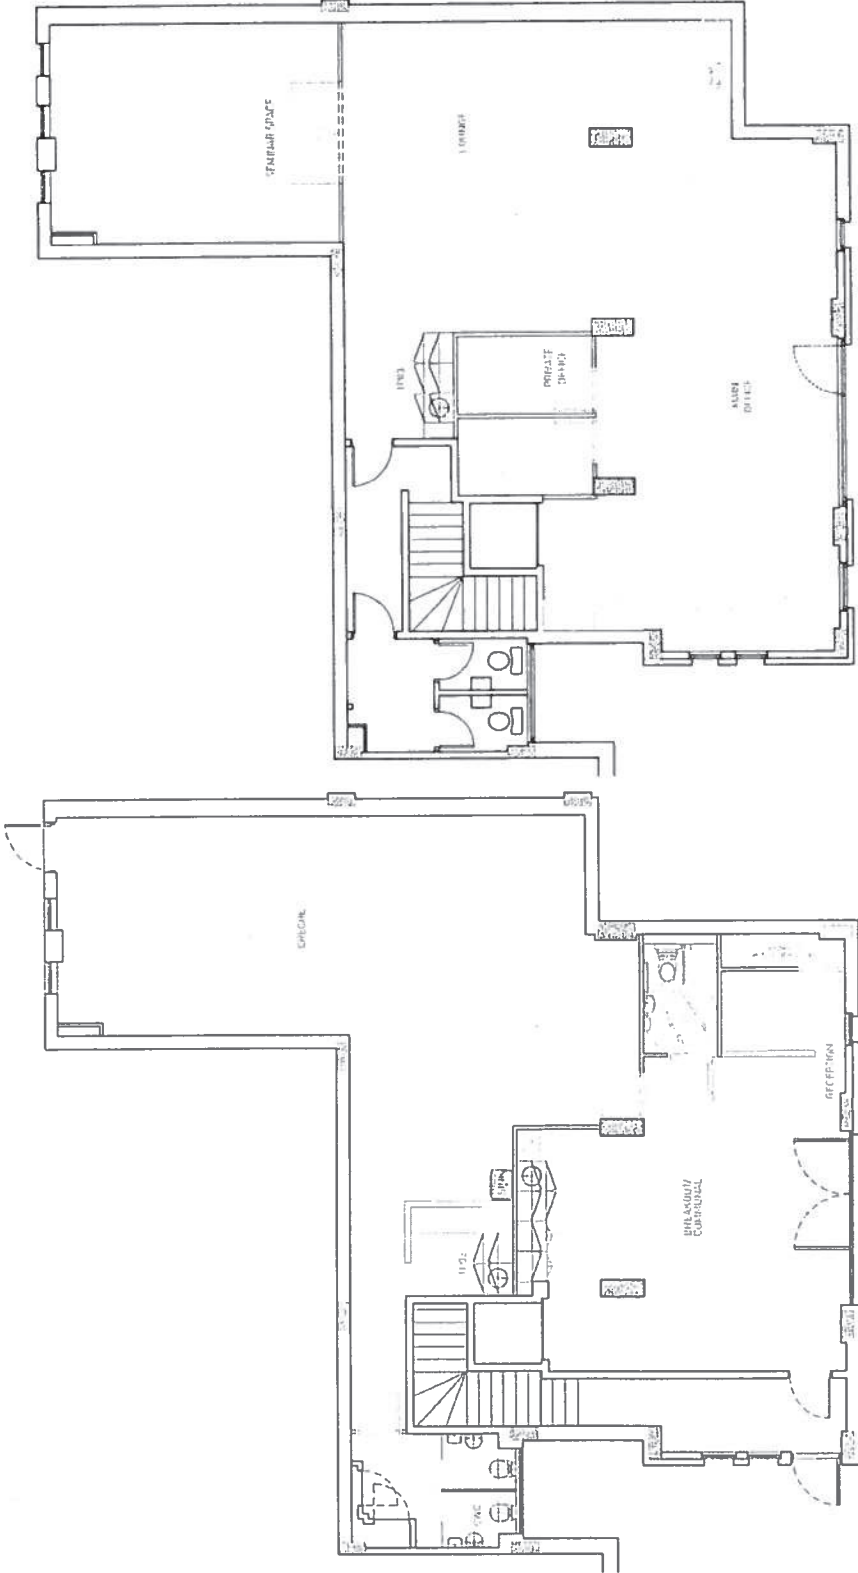

GROUND FLOOR

FIRST FLOOR